


AS BUILT DRAWING

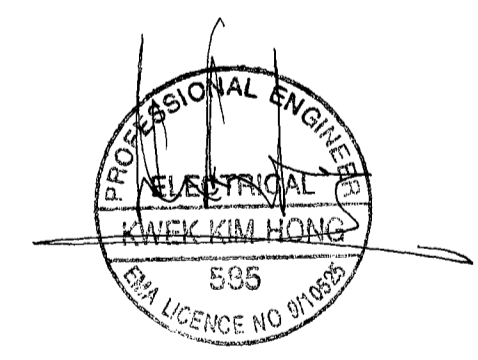

MICROFILMED
05 AUG 2008

CONTRACT ELECTRICAL	
JOB TITLE PUNNGOL WEST CONTRACT 2	
DRAWING TITLE (FOR EST. BLK. NO. 2045) SINGLE LINE DIAGRAM (PART 3)	
DRAWING NO. HB 3338-2000-ES-75 B	SCALE: N.T.S.
DATE: MAR. 2000	DRAWN BY: TEO S.B.
DESIGN ENGR. THOMAS LEE	TEAM LEADER: LOH HOOK LING
APPROVING ENGR. TEO SEOW KOK	STO-BY: CHAN
HEAD, ELECTRICAL HO FUJ CHAN	CHIEF ELECTRICIAN YEO KIAN HUA
HOUSING & DEVELOPMENT BOARD	

NOTES:
 1) FOR ELECTRICAL GENERAL NOTES, REFER TO DRG. NO. HB 3338-2000-ES-2
 2) THE 3P MCB IN THE DISTRIBUTION BOARD ARE FOR DUAL-CIRCUITING LIGHTING POINT AND ARE TO BE USED IN THE CONFIGURATION SHOWN IN THE SCHEMATIC CONNECTION DIAGRAM. FOR DETAILS, REFER TO DRG. NO. HB 3338-2000-ES-146

ELECTRICAL LEGEND	
	HRC FUSE
	CIRCUIT BREAKER
	ISOLATOR
	CONTACTOR
	KWH METER
	RIPPLE CONTROL RECEIVER RELAY SWITCH
	PHASE SELECTOR SWITCH
	VOLTMETER
	AMMETER
	CURRENT TRANSFORMER
	PHASE INDICATOR LIGHTS
	SINGLE PHASE UNFUSED TAP-OFF UNIT
	HOUSE SERVICE/METER BOARD LOCATED IN SERVICE DUCT
	MAXIMUM DEMAND AMMETER
	TIME DELAY RELAY
	EARTH FAULT RELAY
	INVERSE DEFINITE MINIMUM TIME LAG OVERCURRENT RELAY
	OVER CURRENT RELAY
	KEY INTERLOCK BETWEEN COUPLER AND INCOMERS
	EARTH ELECTRODE
	'MG' LIGHT SENSITIVE SWITCH MODEL IC 2000 C/W PHOTOCCELL & ACCESSORIES OR OTHER APPROVED
	TIME SWITCH

AMENDMENT	DATE	TL	STO	DE	AE	AMENDMENT	DATE	DRAWN BY	DE	AE
A	18.9.03	BOD SB	LOW S.E.	TAN K.K.		• SLD. CDT. NO. R1,R2,R3,R4, R4B,R4C,R4D RE ADDED. • SLD. CDT. NO. G4 AMENDED TO SPARE.	18.9.03	BOD SB	LOW S.E.	TAN K.K.
B	1.12.04	C/HIA				AOL OMITTED	1.12.04	C/HIA		