


ROOF PLAN
 FOR EST. BLK. NO. 204B, 204D & 205A
 FOR EST. BLK. 204C TO BE READ HANDED

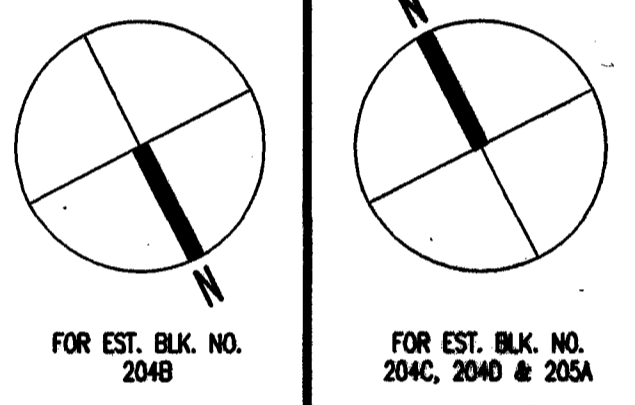

FOR EST. BLK. NO. 204B
 FOR EST. BLK. NO. 204C, 204D & 205A

CERTIFICATION

Mohd. Asaduz Zaman
 NSIC No./Passport No. _____
 being a qualified person, hereby certify that,
 1) subject to any waiver/modification granted under Section 14 of the Act, that the preparation of these building plans and the building works shown on these plans are strictly in accordance with the provisions of the Building Control Act (Cap 29) and the Regulations made thereunder; and
 2) the building works and fire safety works as shown on these plans have been designed in accordance with the provisions of the Code of Practice for Fire Precautions in Buildings 1997, including all amendments applicable up to the date of this submission, the Fire Safety Act and its Regulations, the relevant code of practice or design guidelines, subject to waivers granted under Section 27 of the Act."

Mohd. Asaduz Zaman
 Senior Principal Architect
 Housing & Development Board
 Name & Signature of Qualified Person

I/We confirm at the time of my/our inspection, the works are carried out in accordance with the drawing and the Contract Specifications.

HDB Project Manager/Architect/Engineer's Stamp & Signature	DATE	REMARKS

CONTRACT BUILDING, SANITARY, WATER & GAS INSTALLATION

JOB TITLE
PUNGGOL WEST CONTRACT 2

DRAWING TITLE (FOR EST. BLK. NO. 204B, 204C, 204D & 205A)
ROOF PLAN

DRAWING NO. HB - 3338 - 99 - 35 ^A	SCALE: 1:100	DRAWN BY: XIAO L	TEAM: 205
DATE: OCT 1999	XIAO LIANG	TEAM LEADER:	
IRENE CHANG ARCH-IN-CHARGE	CHAM SIAK STO (D)	STUDIO: 2	
MOHD. A ZAMAN HEAD, STUDIO 2	TONY TAN KENG JOO	CHIEF ARCHITECT	



NOTES
 ● FOR GENERAL NOTES, REFER TO DRAWING NO. HB-3338-99-5

AMENDMENT	DATE	TEAM LEADER	PROJ. STD.	ARCHT. I/C	AMENDMENT	DATE	TEAM LEADER	PROJ. STD.	ARCHT. I/C

AS BUILT DRAWING
 Mohd Asaduz Zaman
 Via President (Architectural)
 Sdn Bhd. Incorporated (Company No. 930)
 B.O.A. Reg. No 930