


PLAN OF LIFT MACHINE ROOM, BOOSTER PUMP ROOM & WATER TANK
FOR EST. BLK. NO. 204B, 204D & 205A

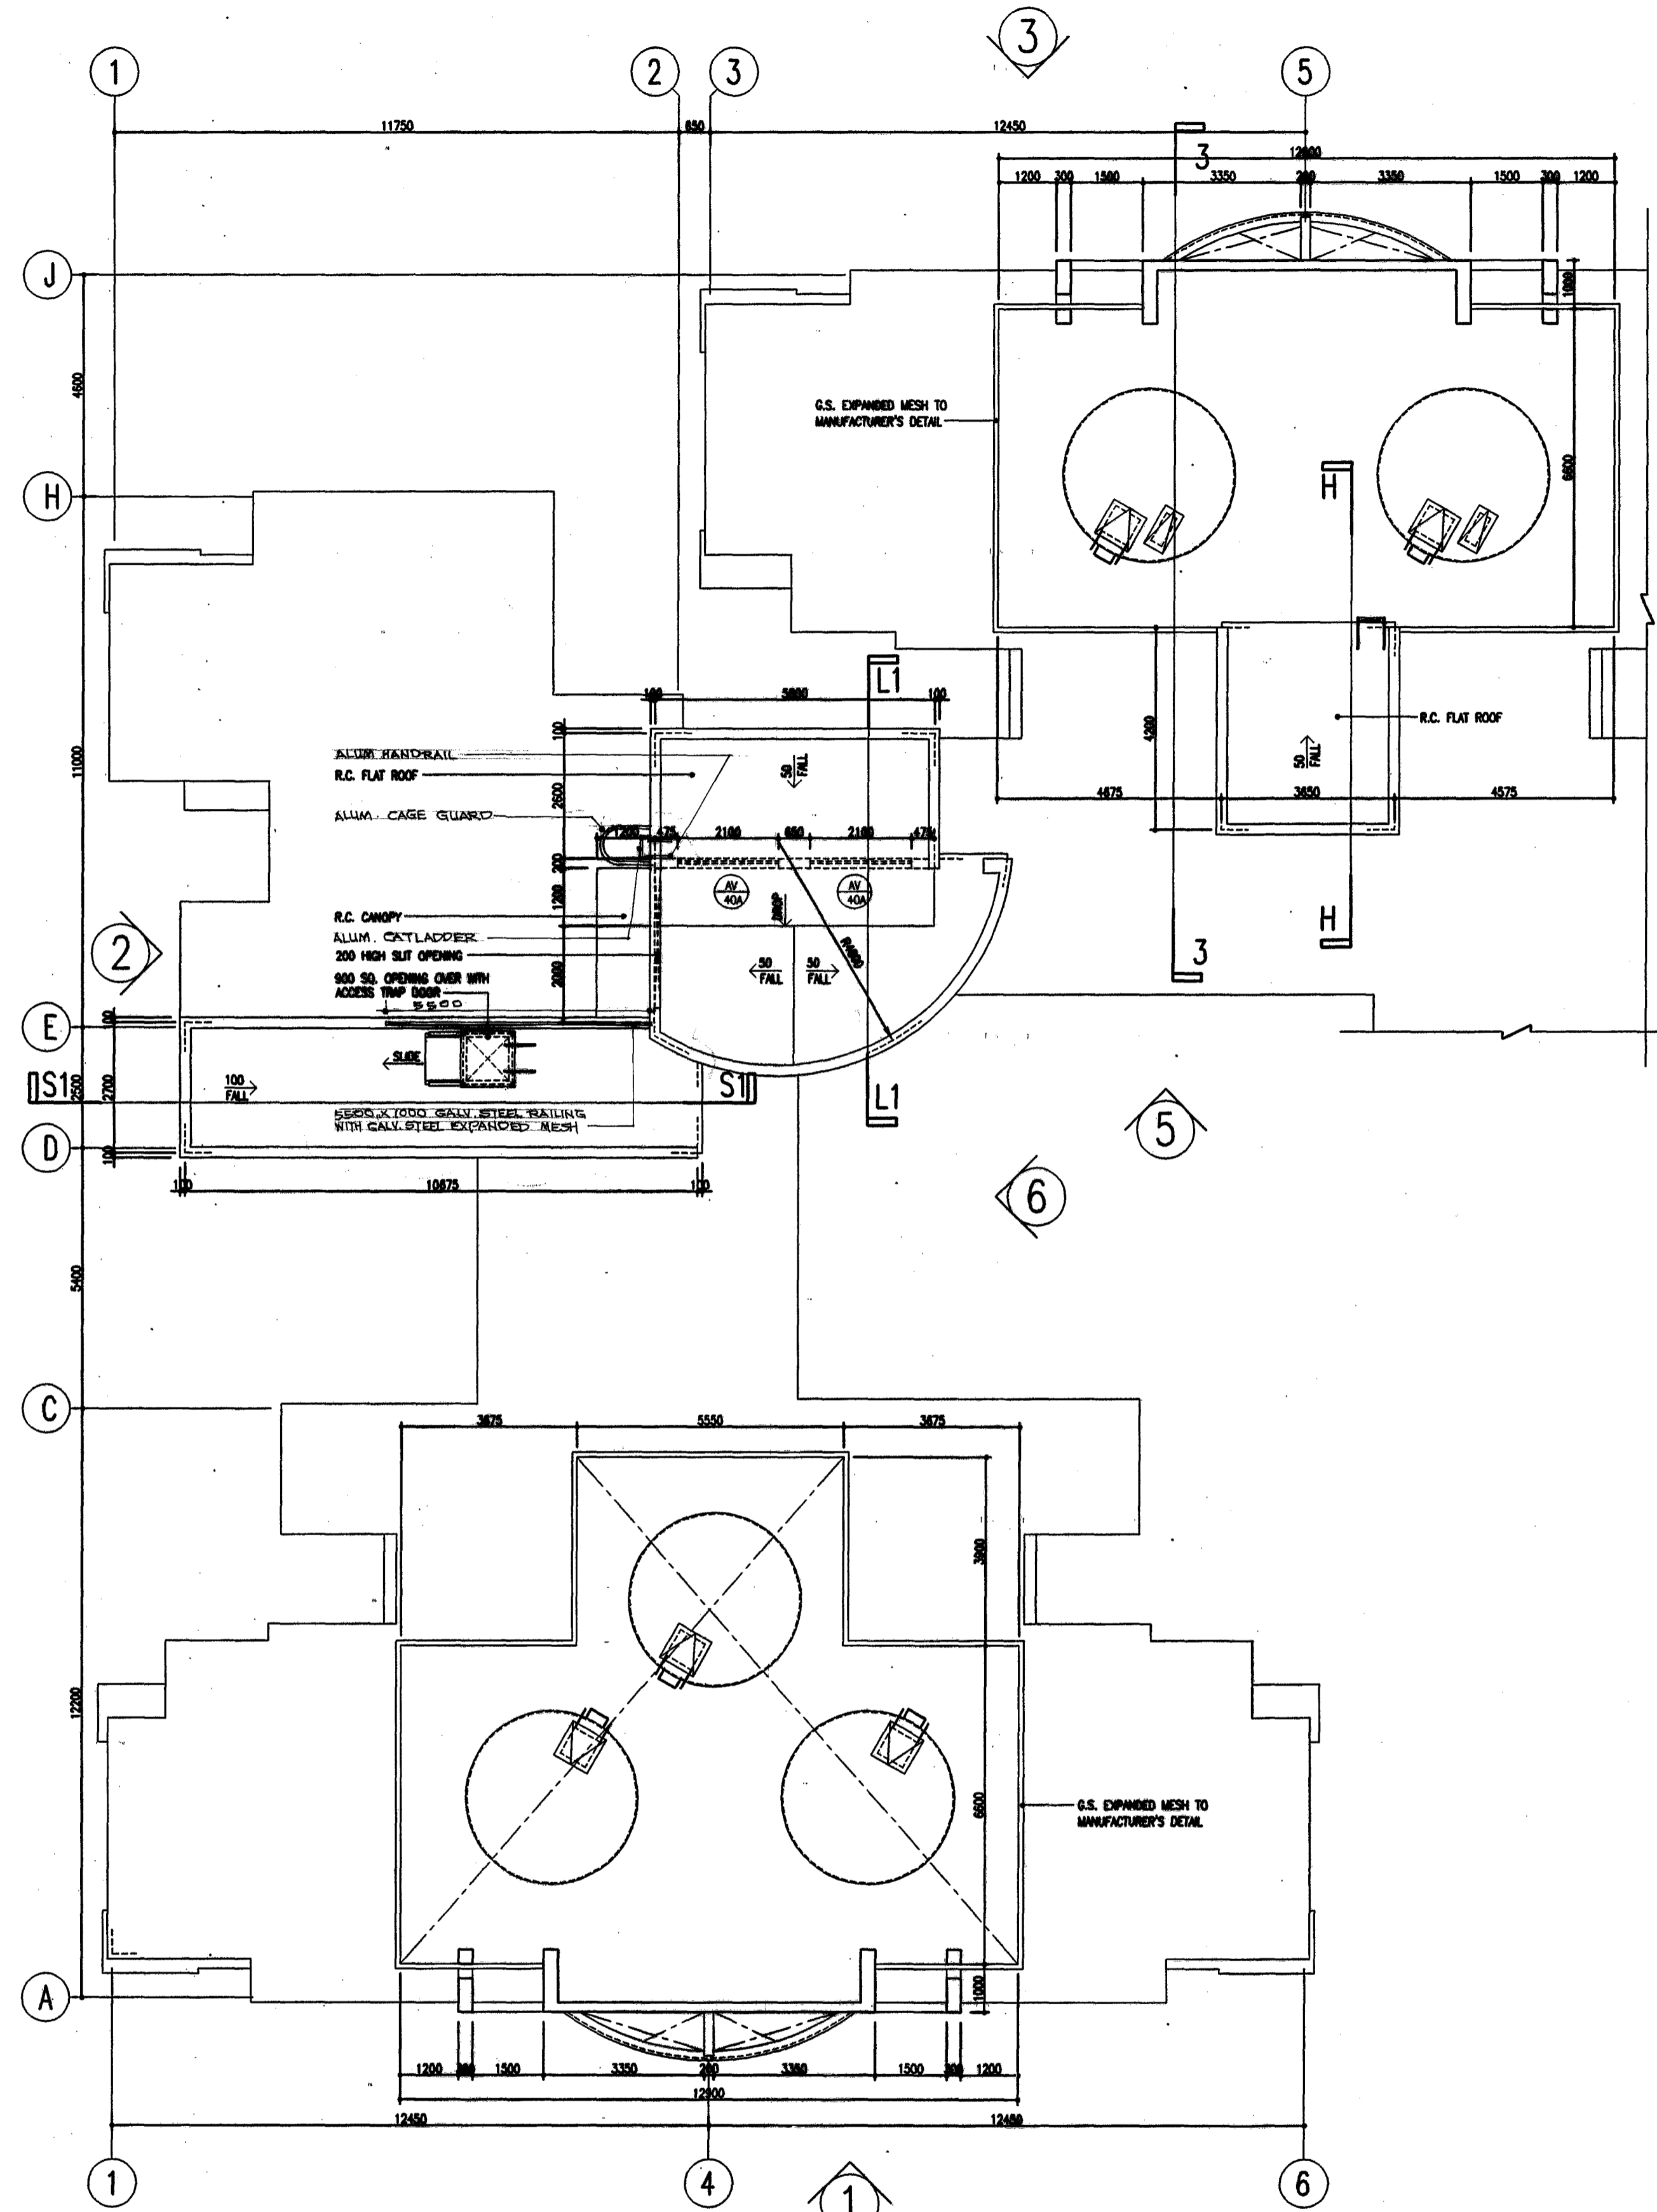


ROOF PLAN OF LIFT MACHINE ROOM, BOOSTER PUMP ROOM & WATER TANK
FOR EST. BLK. NO. 204B, 204D & 205A

NOTES
● FOR GENERAL NOTES, REFER TO DRAWING NO. HB-3338-99-5

AMENDMENT	DATE	TEAM LEADER	PROJ. MGR.	ARCH. I/C	AMENDMENT	DATE	TEAM LEADER	PROJ. MGR.	ARCH. I/C	AMENDMENT	DATE	TEAM LEADER	PROJ. MGR.	ARCH. I/C
1					EXPANDED METAL ROOF GALV STEEL 515 & ALUM. CANTLADDER ADDED NEXT TO BOOSTER PUMP ROOM AS REQUESTED BY ARCH.	JUL 04	CHONG B.C.	CHONG B.C.	CHONG B.C.	1				
2					2) 500 X 1000 HIGH GALV. STEEL RAILING ADDED TO ROOF OF STAIRCASE - ABOVE STAIR & ALUM. CANTLADDER CAGE GUARD & HANDRAIL FOR ACCESS TO ROOF OF LIFT MACHINE ROOM ADDED					2				
3					* THE ABOVE AMENDMENT ARE ACCORDING TO B.C.A. SPECIFICATIONS FOR WATER PREVENTION SYSTEMS 1A/1B/1C					3				

Mohd. Asaduz Zaman
Senior Principal Architect
AS BUILT DRAWING
Surbate International Consultants Pte. Ltd.
BOA Reg. No 930

REFERENCE

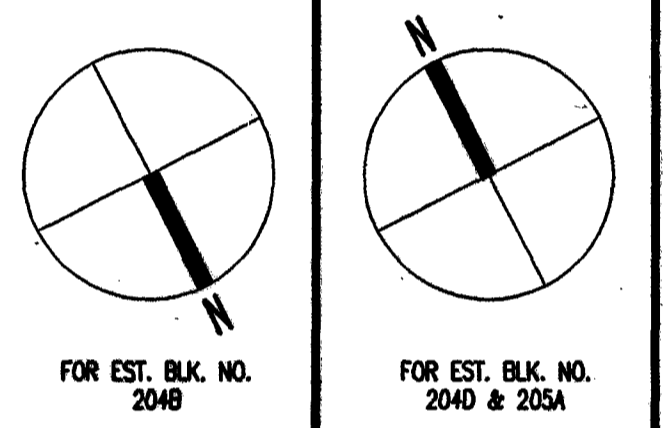

CERTIFICATION

1. Mohd. Asaduz Zaman
NRC No./Passport No. _____
being a qualified person, hereby certify that,
1) subject to any waiver/modification granted under Section 14 of the Act, that the preparation of these building plans and the building works shown on these plans are strictly in accordance with the provisions of the Building Control Act (Cap 28) and the Regulations made thereunder; and
2) the building works and fire safety works as shown on these plans have been designed in accordance with the provisions of the Code of Practice for Fire Preventions in Buildings 1987, including of amendments applicable up to the date of this submission, the Fire Safety Act and its Regulations, the relevant code of practice or design guidelines, subject to waivers granted under Section 27 of the Act.

Mohd. Asaduz Zaman
Senior Principal Architect
Name & Signature of Qualified Person

I/We confirm on the time of my/our inspection, the works are carried out in accordance with this drawing and the Contract Specifications.

HOB Project Manager/Architect/Engineer's Stamp & Signature	DATE	REMARKS

CONTRACT BUILDING, SANITARY, WATER & GAS INSTALLATION

JOB TITLE
PUNGGOL WEST
CONTRACT 2

DRAWING TITLE (FOR EST. BLK. NO. 204B, 204D & 205A)
PLAN & ROOF PLAN OF LIFT MACHINE ROOM, BOOSTER PUMP ROOM & WATER TANK

DRAWING NO. HB - 3338 - 99 - 36 B

SCALE: 1:100
DATE: OCT 1999
DRAWN BY: XIAO L. TEAM: 205
YAO LIANG
TEAM LEADER
IRENE CHIANG
ARCH-IN-CHARGE
MOHD. A. ZAMAN
HEAD, STUDIO 2
CHOW S.K.
STO (D)
STUDIO: 2
TONY TAN KENG JOO
CHIEF ARCHITECT

HOUSING & DEVELOPMENT BOARD
HB.3338.99.054 (AC)